

Date: Thursday, 6/29/2006 8:31:31 AM
 User: Kim Johnston

Process Sheet

Customer : CU-DAR001 Dart Helicopters Services	Drawing Name : RUBBER SPACER
Job Number : 27768	
Estimate Number : 11865	
P.O. Number : N/A	Part Number : D23971
This Issue : 6/29/2006 S.O. No. : N/A	Drawing Number : D2397 REV C
Prsht Rev. : NC	Project Number : N/A
First Issue : N/A Type : SMALL /MED FAB	Drawing Revision : C
Previous Run : 27401	Material : N/A
Written By : <i>See Comment Below</i>	Due Date : 7/30/2006
Checked & Approved By : <i>06/06/29</i>	Qty: 20 Um: 40 Each
Comment : Est. A98.12.15 New Issue DM	

Additional Product

Job Number:



Seq. #:	Machine Or Operation:	Description :
----------------	------------------------------	----------------------

1.0	D2397	Cushion
-----	-------	---------



Comment: Qty.: 0.6750 sf(s)/Unit Total : 6.7496 sf(s)
 D2397 1/16" NEOPRENE BATCH: 16919

M.F. 06/07/07

2.0	SMALL FAB 1	SMALL & MEDIUM FAB RESOURCE 1
-----	-------------	-------------------------------



Comment: SMALL & MEDIUM FAB RESOURCE 1
 Cut and punch per Dwg D2397 using Template DT 8199 and Punch DT 8200

M.F. 06/07/07 20

3.0	QC5	INSPECT WORK TO CURRENT STEP
-----	-----	------------------------------

**Comment:** INSPECT WORK TO CURRENT STEP

4.0	PACKAGING 1	PACKAGING RESOURCE #1
-----	-------------	-----------------------



Comment: PACKAGING RESOURCE #1
 Identify and Stock
 Location: ST 42

LB 06/08/01

5.0	DC	DOCUMENT CONTROL
-----	----	------------------



Comment: DOCUMENT CONTROL
 Inspection Level 21

DP 06/08/01

Job Completion



CJ06/08/01

W/O:		WORK ORDER CHANGES					
DATE	STEP	PROCEDURE CHANGE	By	Date	Qty	Approval Mfg / Design Mgr	Approval QC Inspector

NCR:		WORK ORDER NON-CONFORMANCE (NCR)						
DATE	STEP	Description of NC Section A	Corrective Action Section B			Verification Section C	Approval Design Mgr	Approval QC Inspector
			Initial Design Mgr	Action Description Design Mgr	Sign & Date			

Part No: _____ PAR #: _____ Fault Category: _____ NCR: Yes ☐ No ☒ DQA: ☒ Date: 06/08/01

NOTE: Date & initial all entries

QA: N/C Closed: _____ Date: _____



DESIGN BW	DRAWN BY <i>[Signature]</i>	DART AEROSPACE LTD HAWKESBURY, ONTARIO, CANADA	
CHECKED <i>KE</i>	APPROVED <i>[Signature]</i>	DRAWING NO. D2397	REV. C SHEET 1 OF 1
DATE 98.12.03	TITLE RUBBER CUSHION		SCALE 2:3
A	95.03.22	NEW ISSUE	
B	96.02.16	ADDED D2397-3	
C	98.12.03	D2397-3 REDESIGNED; ADDED D2397-5	


RELEASED
98.12.14 KE

~~SUPERCEDED BY~~


UNDER REVIEW

01.03.15 CP
DESIGN OK, BUT CHECK
WITH JBS BEFORE
MANUFACTURE

CP 04.11.05

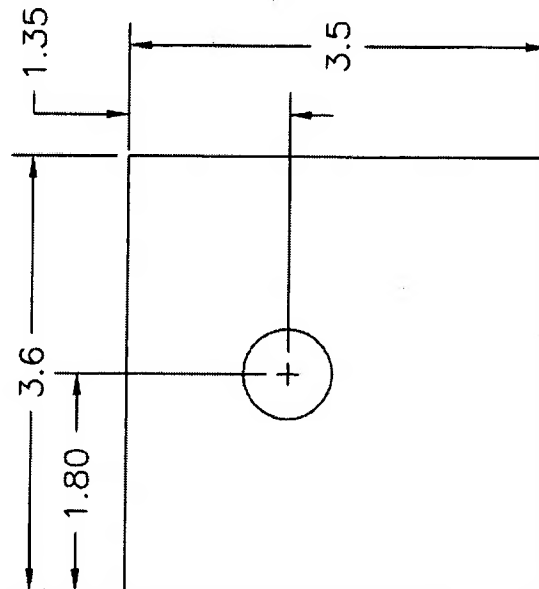


D2397-5
CUT USING DT8198

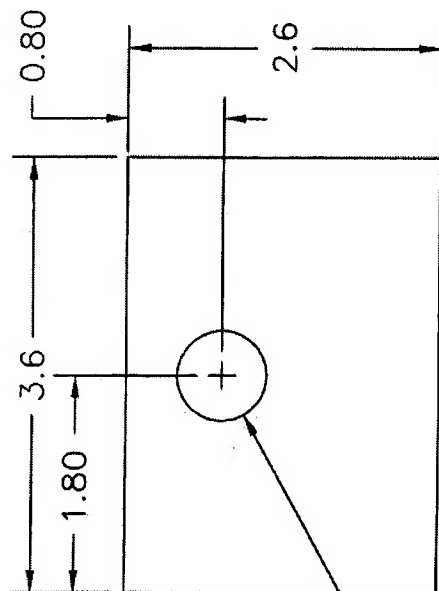

D2397-1
CUT USING DT8199

Ø0.75
(TYP)

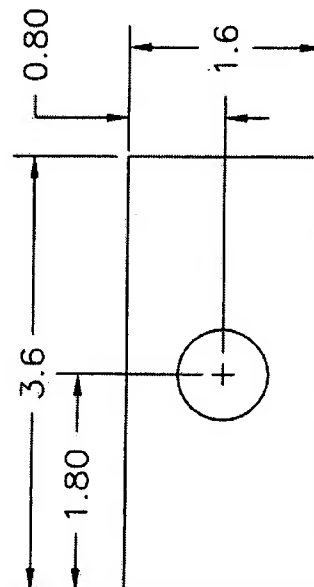

D2397-3
CUT USING DT8199

SHOP COPY
RETURN TO
ENGINEERING
UNCONTROLLED COPY
SUBJECT TO AMENDMENT

MATERIAL: 60 DUROMETER NEOPRENE 1/16" THICK
(POSSIBLE SUPPLIER: ACCURATE RUBBER, P/N 251000002)
TOLERANCES PER DART QSI 018 UNLESS OTHERWISE NOTED